
VICINITY MAP 1930 PACIFIC AVENUE, DALLAS TEXAS 75201

KEY PLAN 1930 PACIFIC AVENUE, DALLAS TEXAS 75201 N.T.S.

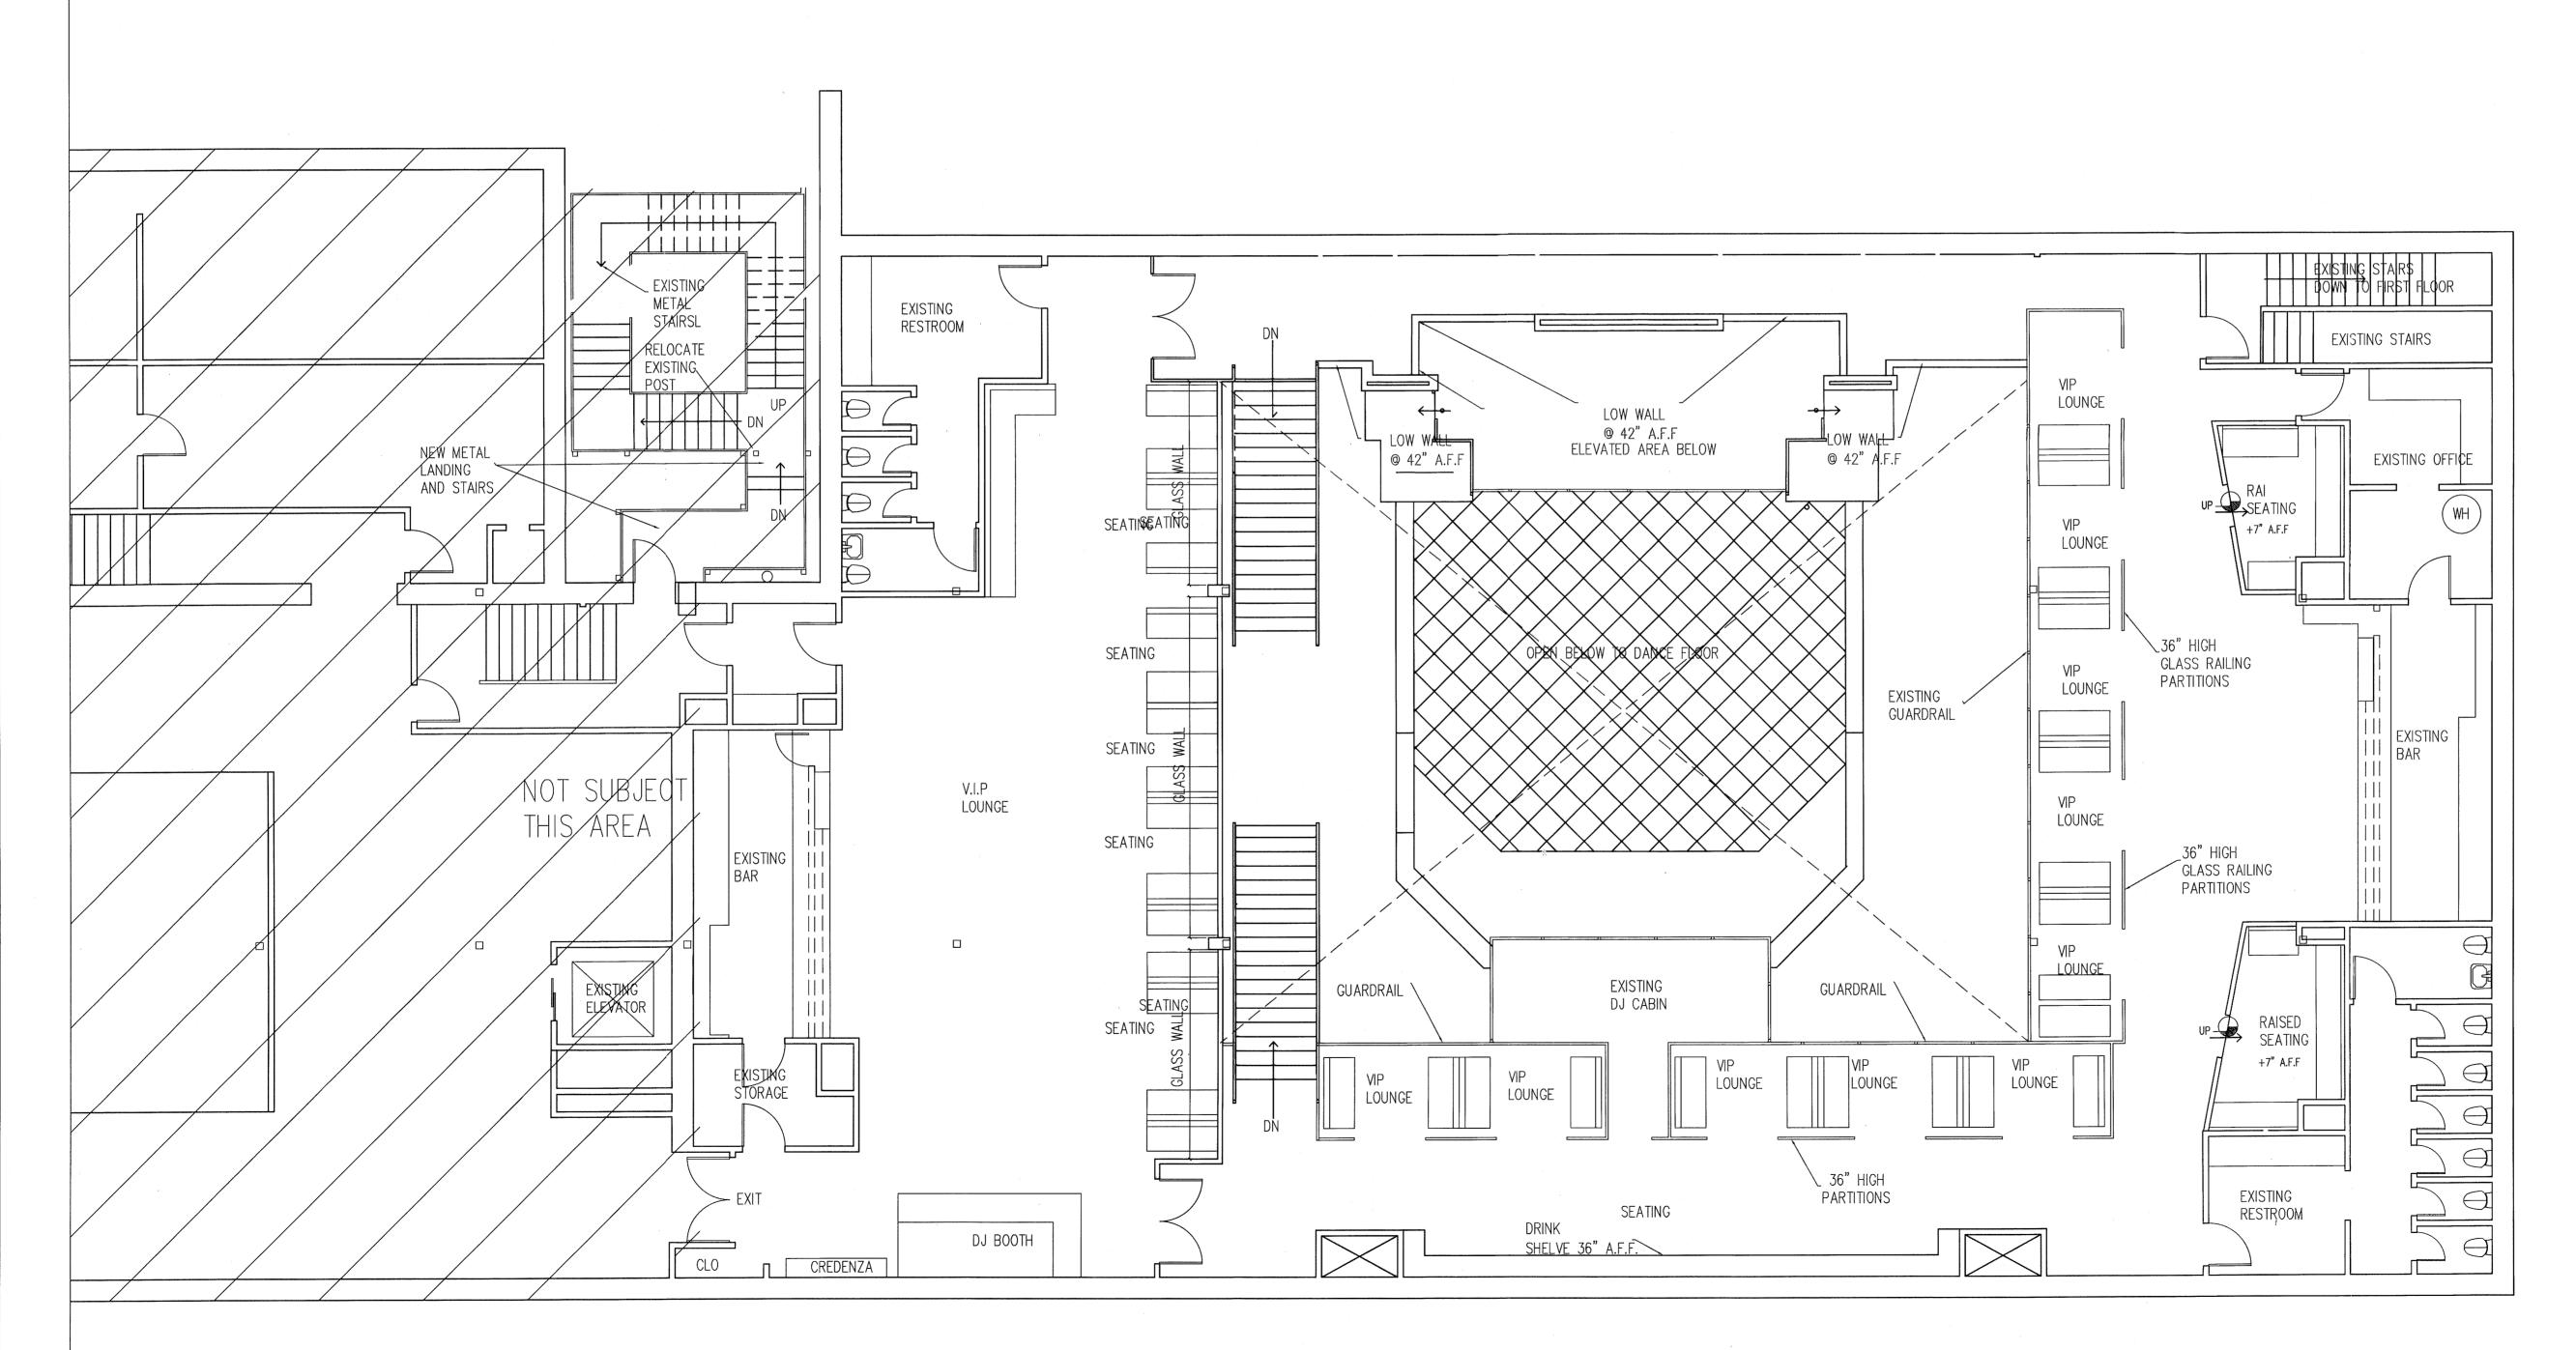

01 AS BUILT SECOND LEVEL 6,799 S.F. 2ND FLOOR

SCALE : 3/16= 1'-0" PLAN TRUE NORTH NORTH

AS-BUILT-2

REVISIONS:

DATE: MAY. 29, 2013

JOB NUMBER
MEDUSA 01