


AS-BUILT SURVEY

I hereby certify that I have this date, made a careful and accurate survey on the ground of the AS-BUILT IMPROVEMENTS located on 6343 Lake June Road in the City of Dallas, Texas. BEING 1.54 acres situated in Dallas City Block 6235 in the John Beernan Survey, Abstract No. 98, in the City of Dallas, Dallas County, Texas.



SCALE 1" = 50'

CITY BLOCK 6235

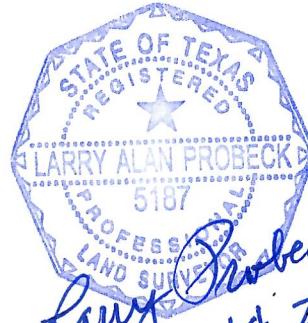

Larry Probeck
Nov. 14, 2019


OWNER:
 786 CHARCO BLANCO, LLC
 INST. # 201600137216
 O.P.R.D.C.T.

PROPOSED
 LOT 2, BLOCK D/6235
 JOOMA ADDN. NO. 2

5/8" IRF (C.M.) "PROBECK"

5/8" IRF (C.M.) "PROBECK"

N 89°50'25" E 314.49'

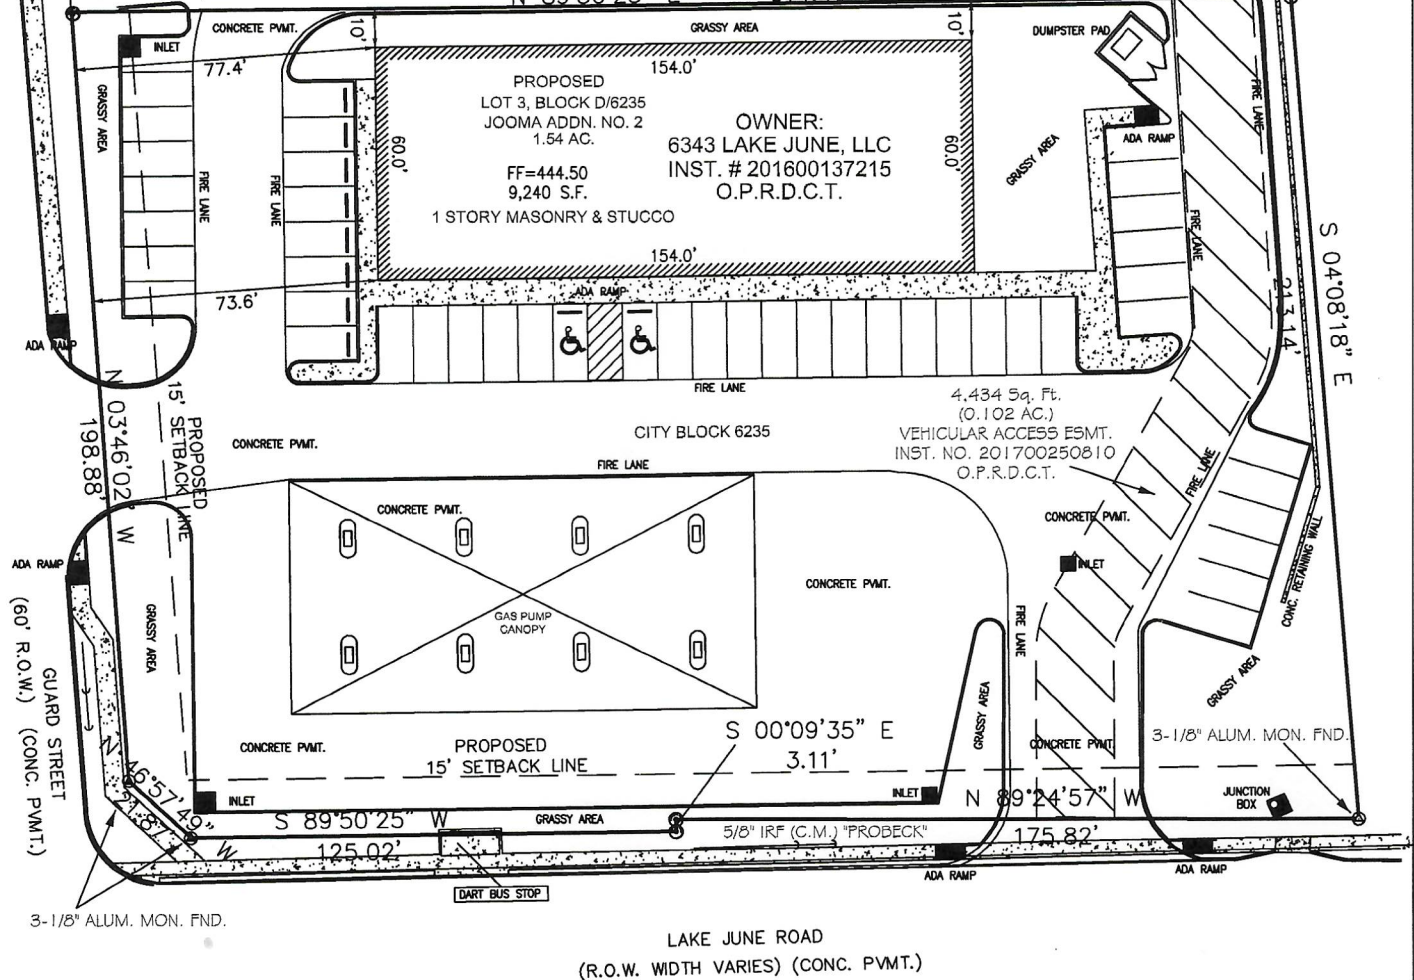

Z190-126(A)

DRAWN BY: L. A. P.	PROJECT	SHT. NAME	SHT. NO.
DATE: NOV. 14, 2019	AS-BUILT SURVEY	PROBECK LAND SURVEYORS	1 OF 1
DWG. NO.: 201971	6343 LAKE JUNE RD.	PO BOX 550695	
SCALE: 1" = 50'	CITY BLOCK D/6235	DALLAS, TEXAS 75355-0695	
	DALLAS, TEXAS	(214) 549-5349	
		FIRM NO. 10042600	