


VICINITY MAP 1930 PACIFIC AVENUE, DALLAS TEXAS 75201

AS BUILT
MEDUSA
1930 PACIFIC
DALLAS TX. 75201

KEY PLAN 1930 PACIFIC AVENUE, DALLAS TEXAS 75201 N.T.S.

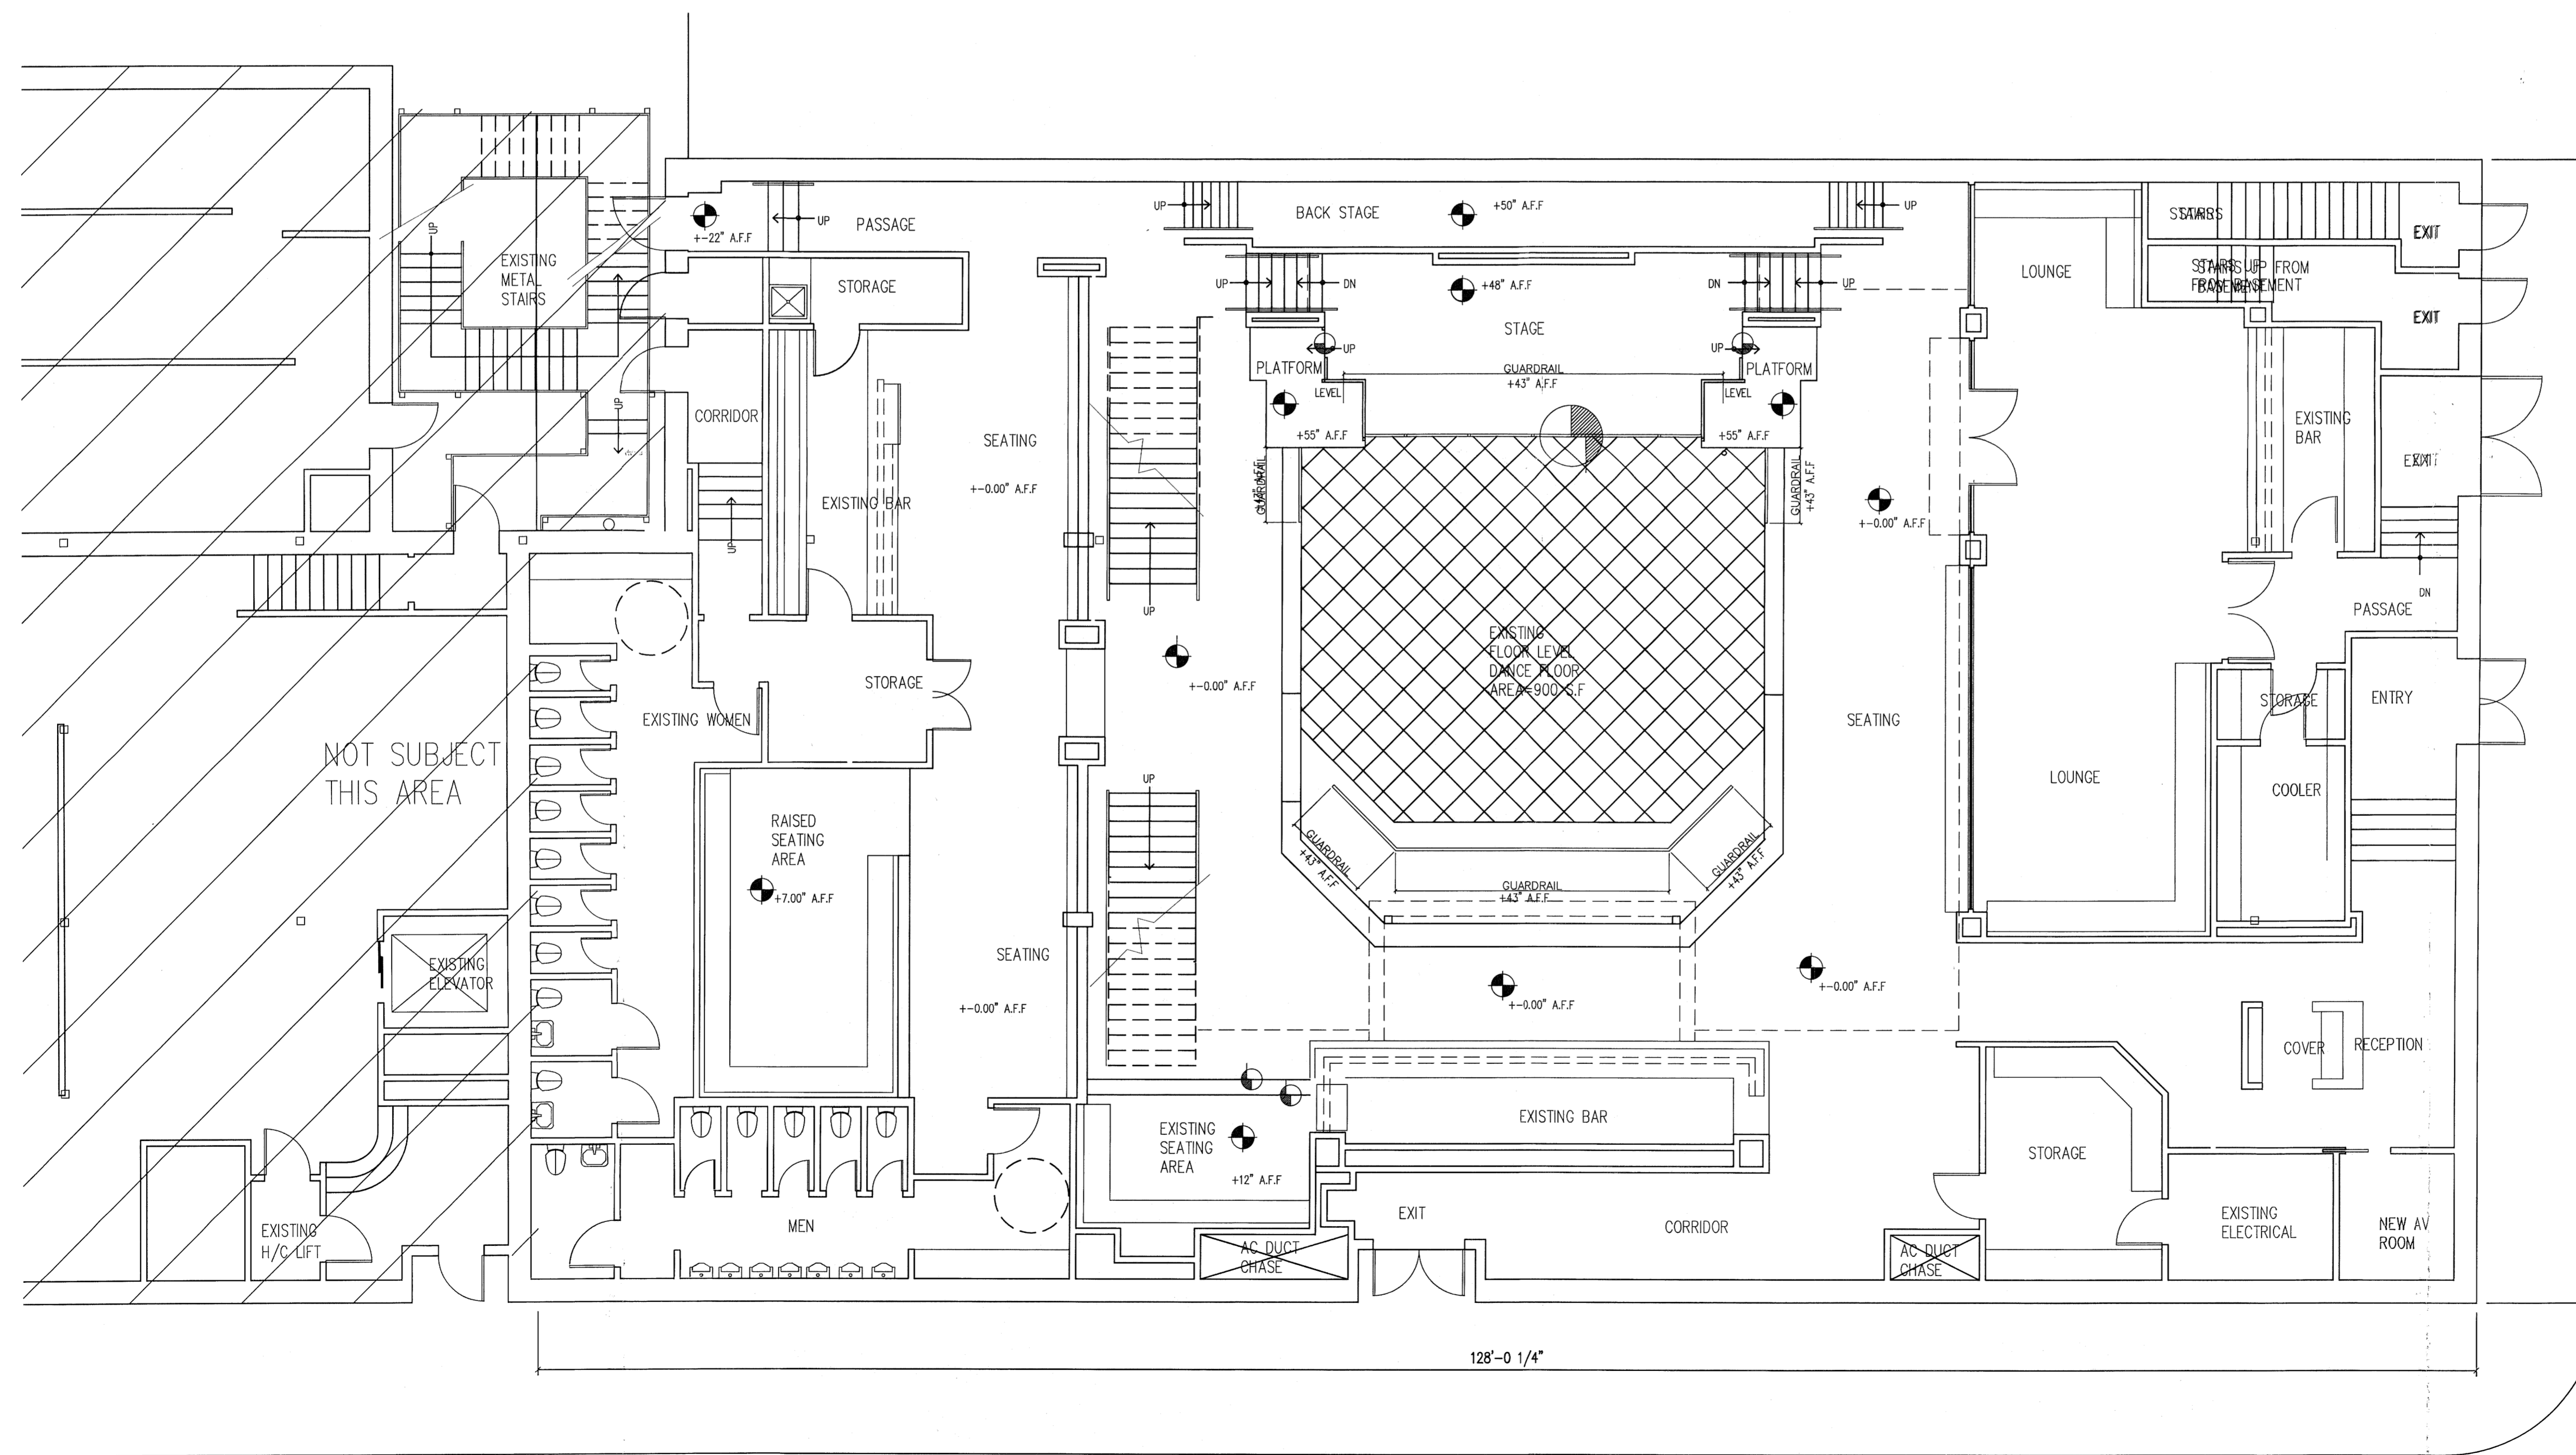

75'-0"
PACIFIC AVENUE

HARDWOOD STREET

01 AS BUILT FIRST LEVEL
9,393 S.F. 1ST FLOOR
TOTAL 16,192 S.F OF BUILDING

SCALE: 3/16" = 1'-0"
PLAN TRUE
NORTH NORTH

This Plan as shown is intended to provide a general indication of the location and general character of the work to be performed. It is not intended to be used as a contract document. The contractor shall be responsible for verifying the accuracy of the information shown on this plan. No warranty is made by the architect for the accuracy of the information shown on this plan. THE ARCHITECT SHALL NOT BE RESPONSIBLE FOR THE ACCURACY OF THE INFORMATION SHOWN ON THIS PLAN.

REVISIONS:
DATE: MAY. 29, 2013
MODEL:
JOB NUMBER: MEDUSA 01

AS-BUILT-1
1 OF 2

Z150-209