


VICINITY MAP 1930 PACIFIC AVENUE, DALLAS TEXAS 75201

AS BUILT  
**MEDUSA**  
 1930 PACIFIC  
 DALLAS TX. 75201

KEY PLAN 1930 PACIFIC AVENUE, DALLAS TEXAS 75201 N.T.S.

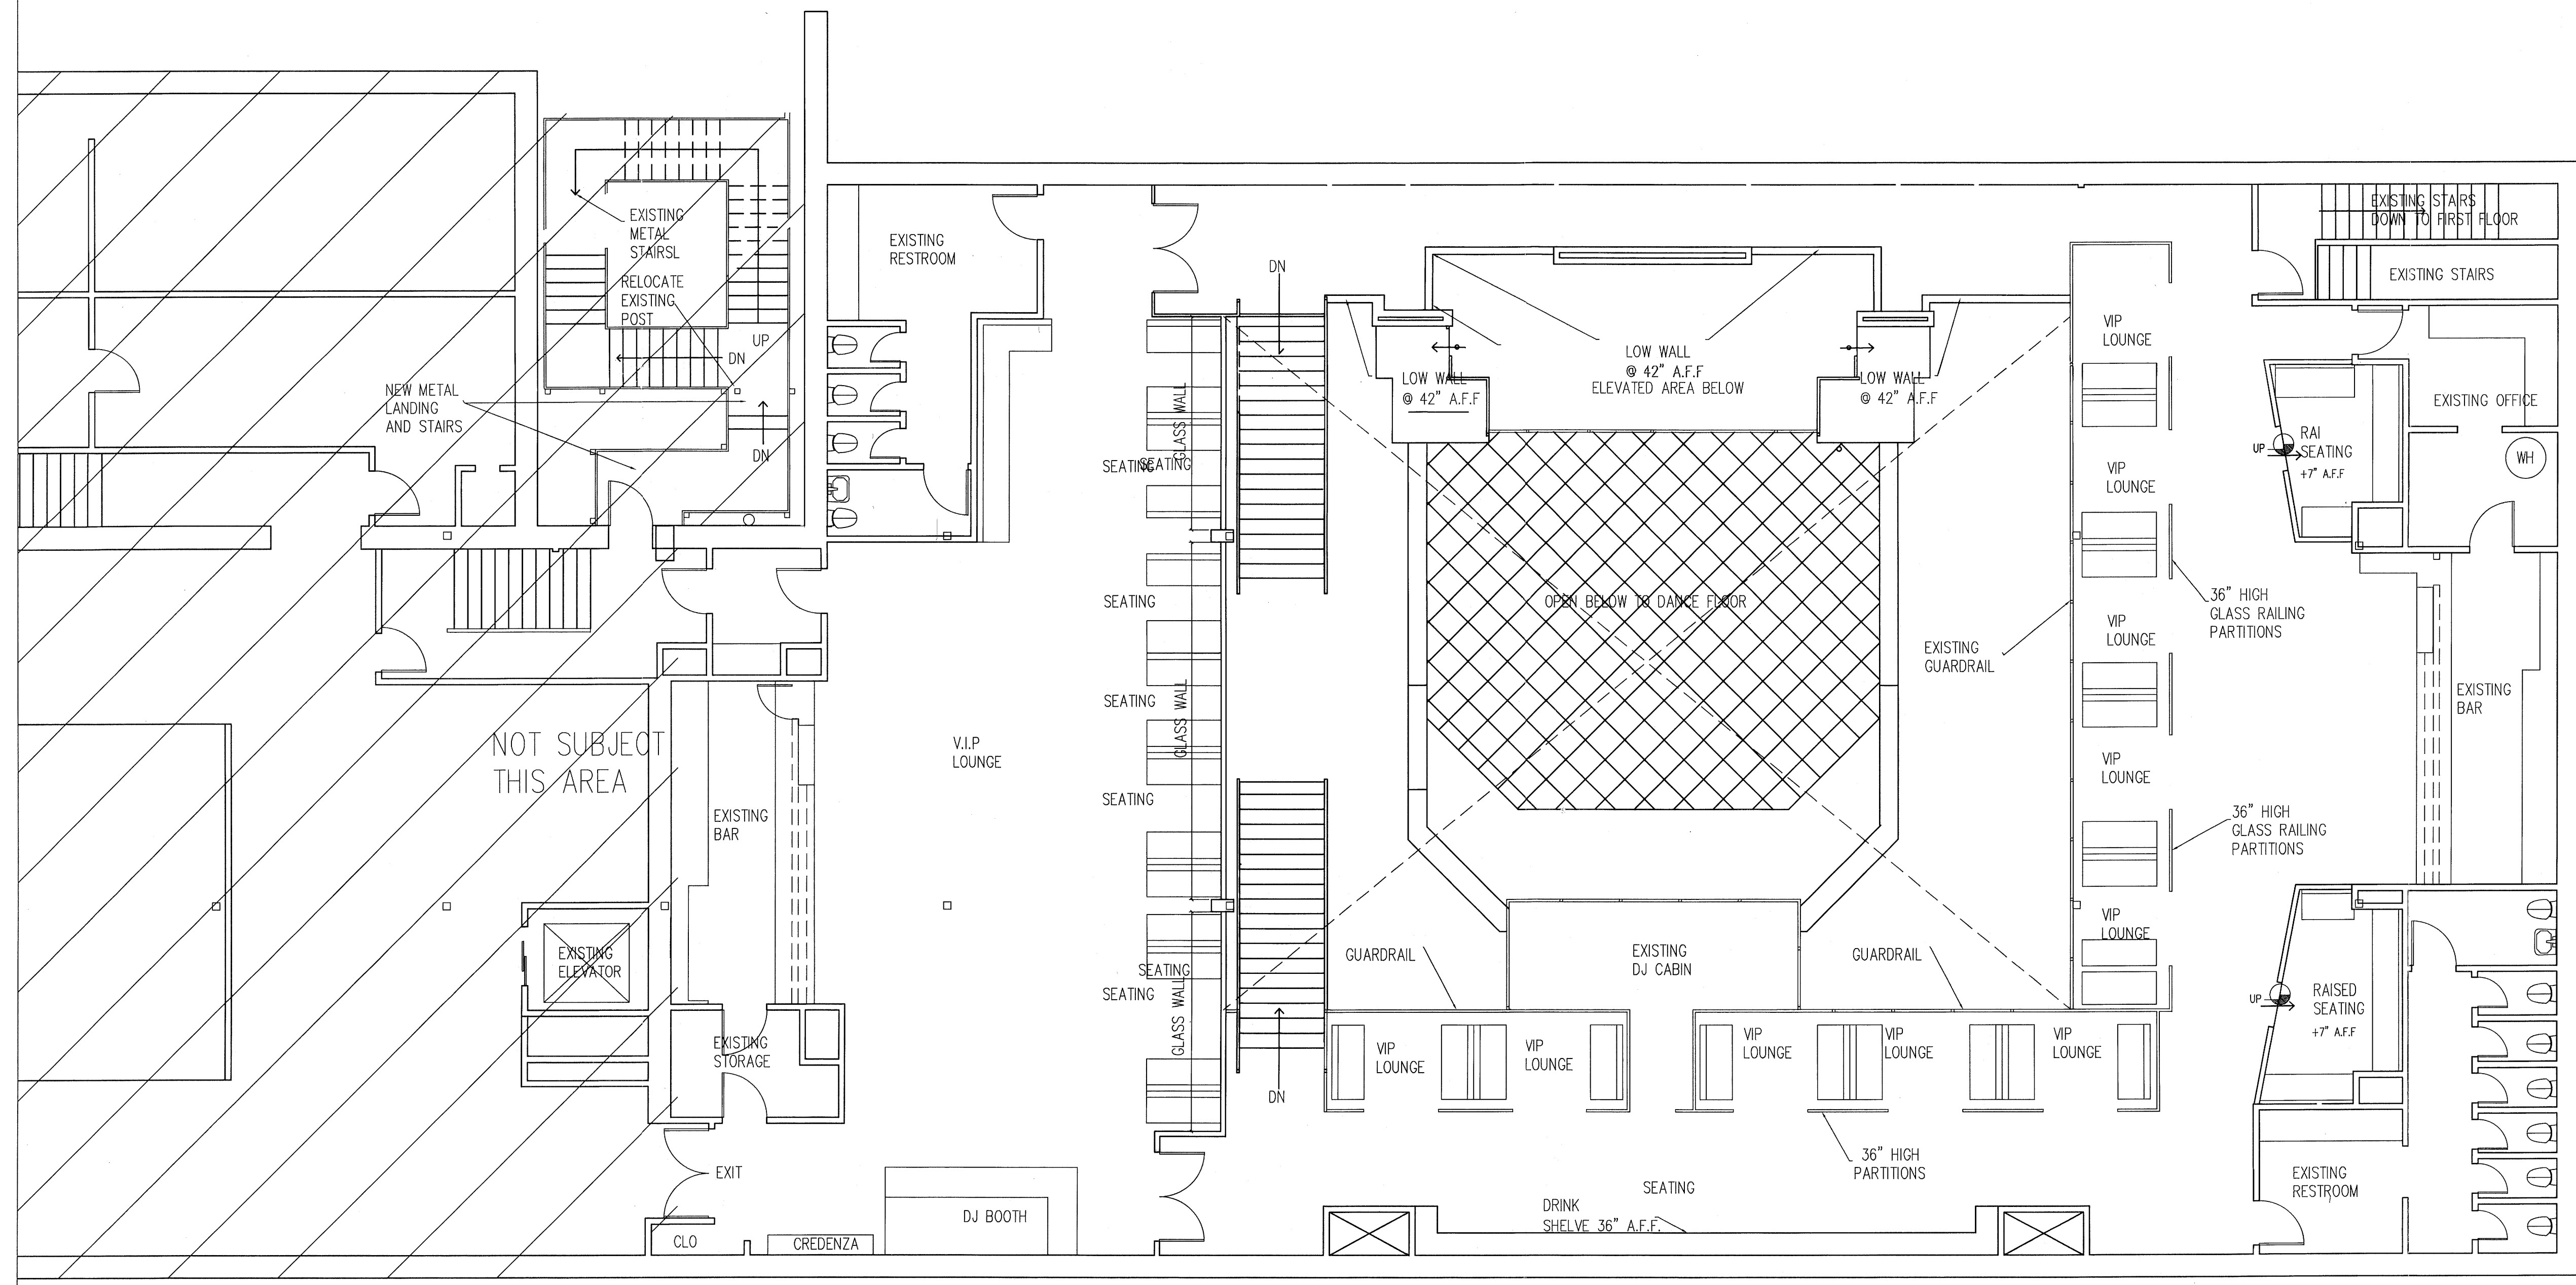

This plan is intended to provide basic information regarding the proposed construction. It is not a contract. The contractor shall be responsible for verifying all dimensions and conditions of the existing building and for obtaining all necessary permits. The contractor shall be responsible for coordinating with all other trades and for ensuring that all work is completed in accordance with the approved plans and specifications. The contractor shall be responsible for obtaining all necessary permits and for ensuring that all work is completed in accordance with the approved plans and specifications. The contractor shall be responsible for obtaining all necessary permits and for ensuring that all work is completed in accordance with the approved plans and specifications.

AS BUILT - 2013

REVISIONS:
DATE: MAY. 29, 2013
MODEL:
JOB NUMBER: MEDUSA 01

01 AS BUILT SECOND LEVEL  
 6,799 S.F. 2ND FLOOR  
 SCALE: 3/16" = 1'-0"  
 PLAN TRUE NORTH